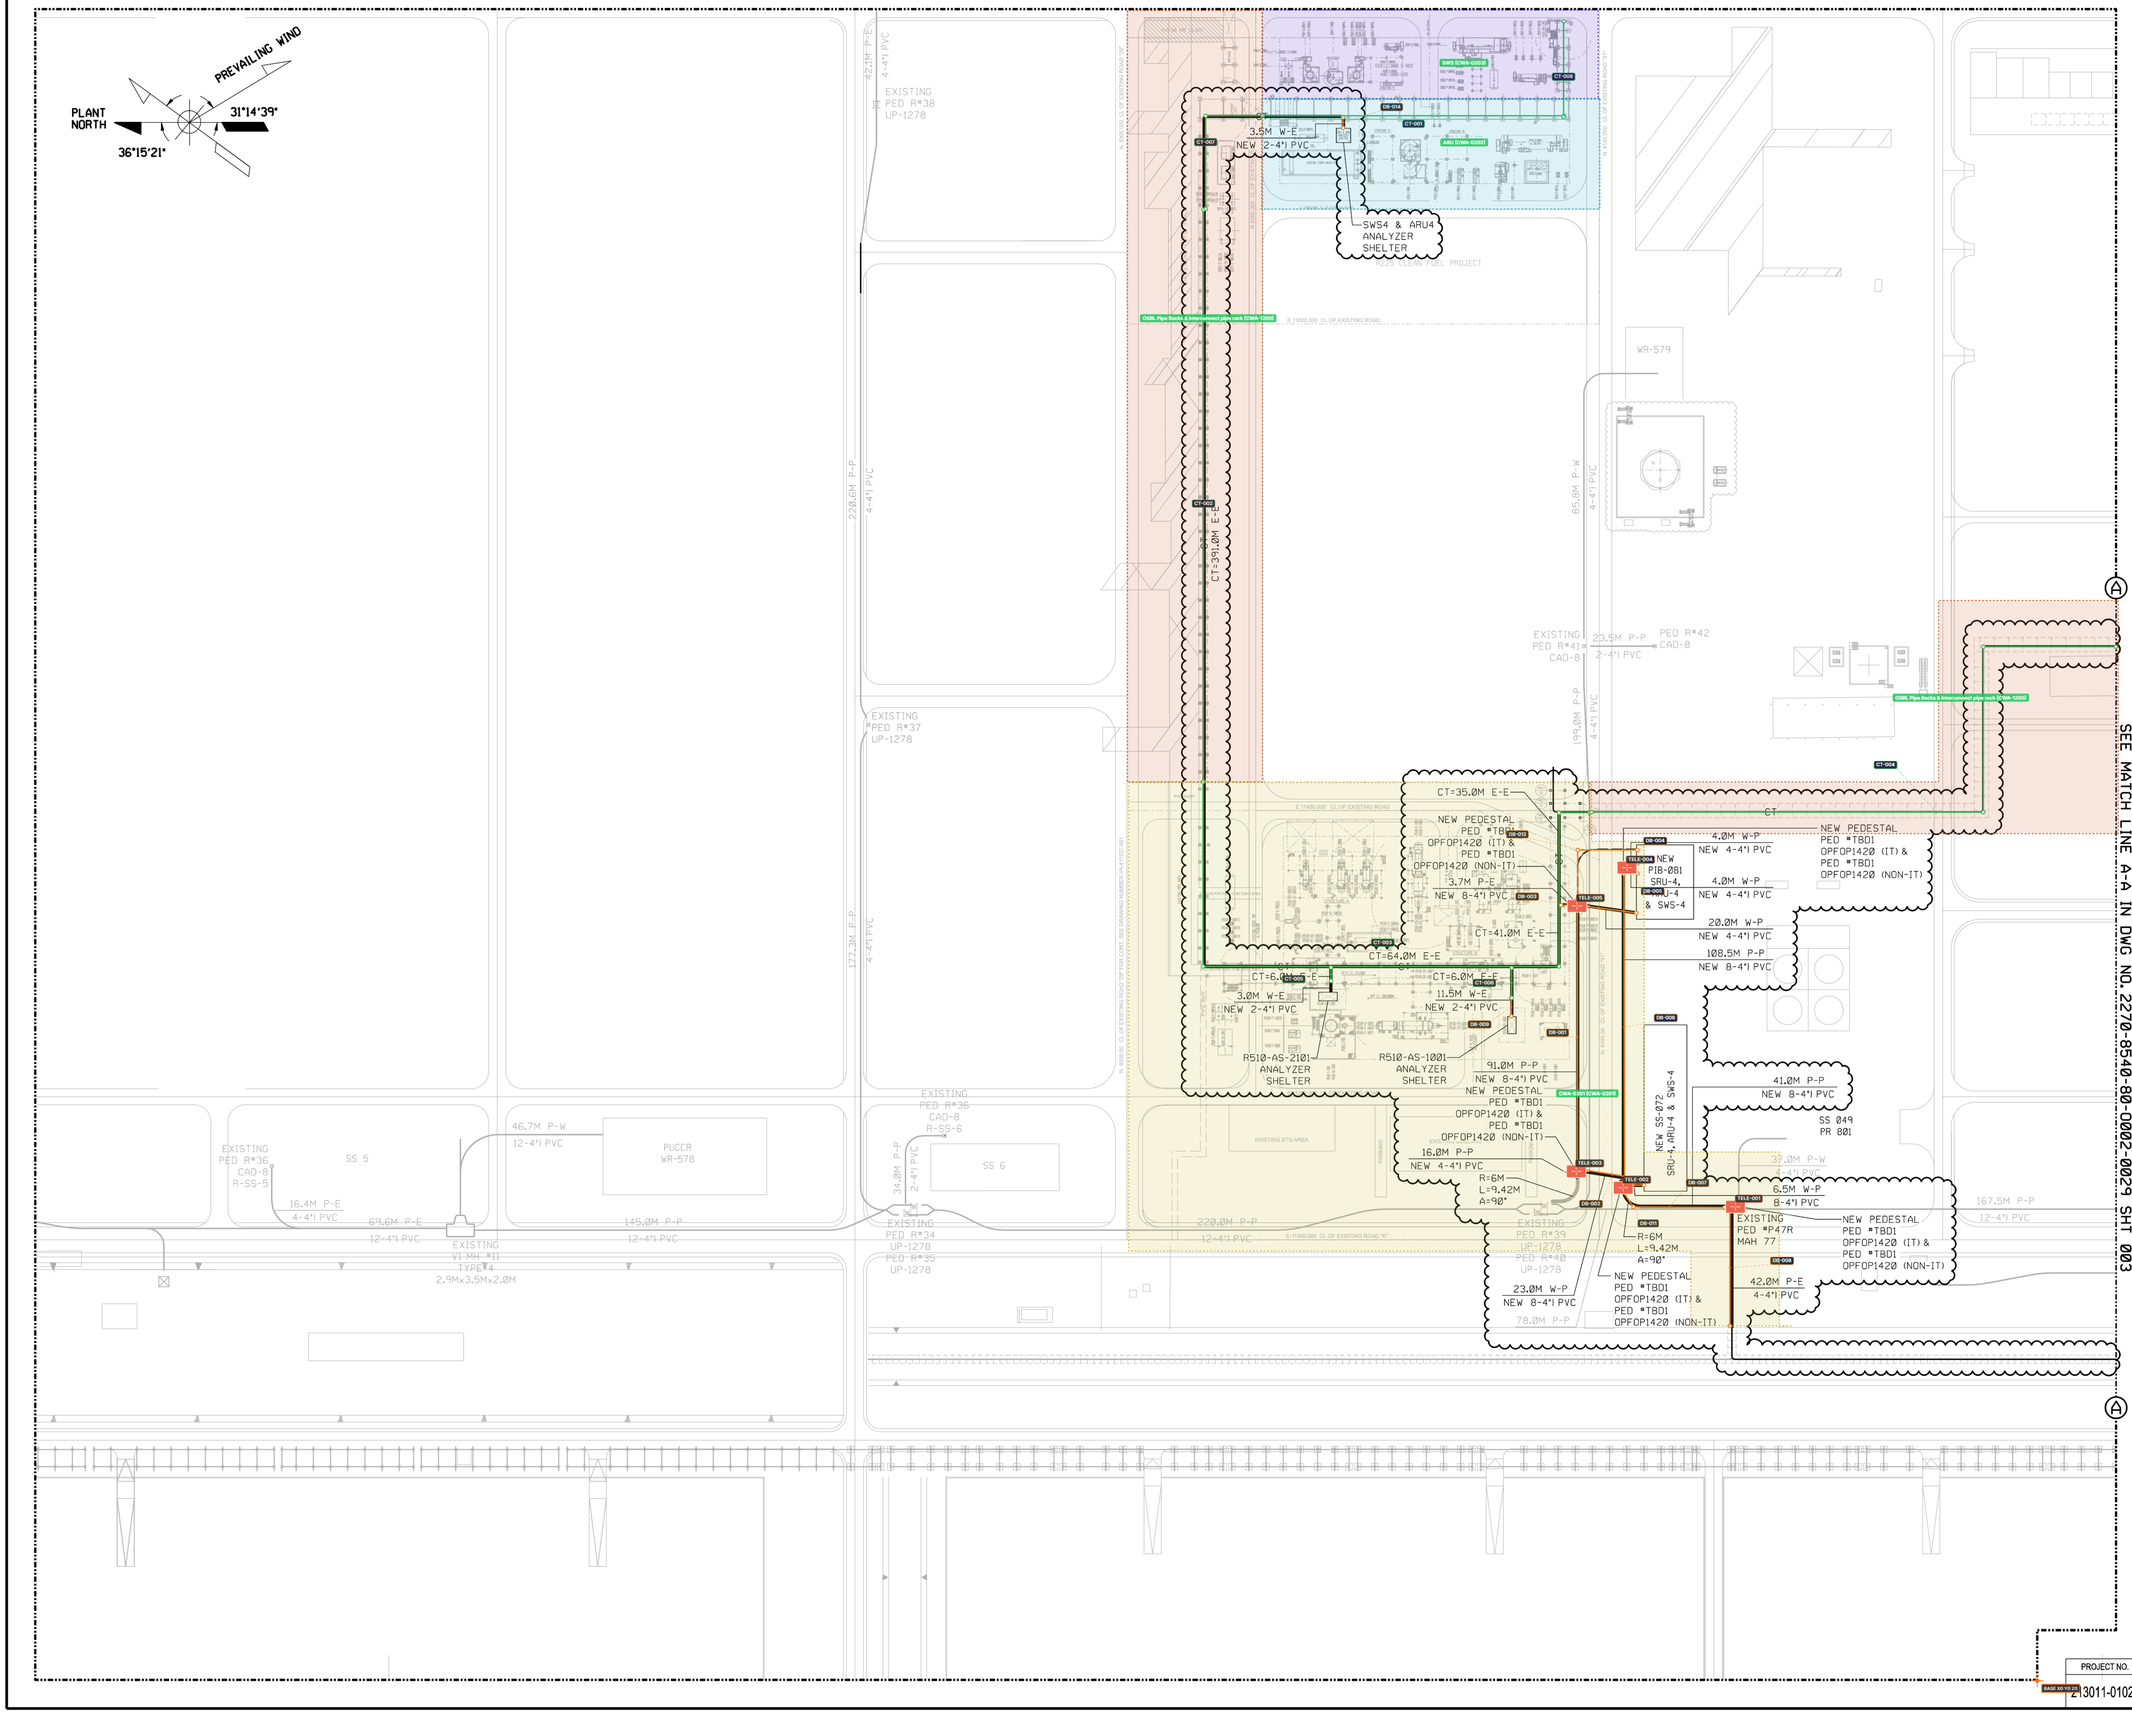

NOTES:

1. ALL DIMENSIONS ARE IN METERS UNLESS OTHERWISE NOTED.
2. ACTUAL CABLE LOCATION AND UTM COORDINATES SHALL BE PROVIDED ON THE DETAILED DESIGN STAGE.
3. WHERE EXISTING COMMUNICATION DUCT BANK ARE AVAILABLE, FOC SHALL UTILIZED SPARE DUCT OR SUBDUCT BASED ON THE MANDRELLING REPORT.
4. THIS DRAWING IS FOR FEED ONLY, ALL NECESSARY DETAILS SHALL BE PROVIDED IN THE DETAIL DESIGN STAGE.
5. THIS DRAWING IS BASED ON A PRELIMINARY PLOT PLAN AND MAY NOT REFLECT THE LATEST REVISIONS. ALL TELECOMMUNICATION LAYOUTS ARE SUBJECT TO CHANGE UPON ISSUE AND VERIFICATION OF THE FINAL APPROVED PLOT PLAN DURING THE 90%. HOWEVER, SUCH CHANGES WILL NOT AFFECT THE OVERALL TELECOMMUNICATION DESIGN PHILOSOPHY, WHICH REMAINS VALID AND APPLICABLE REGARDLESS OF PIPELINE ROUTING OR PLOT PLAN ADJUSTMENTS.

LEGEND

X	DENOTES NOTE NUMBER
	LIGHT LINE WEIGHT DENOTES EXISTING
	BOLD LINE WEIGHT DENOTES PROPOSED
	PROPOSED NON-IT DUCT BANK
	IT DUCT BANK
CT	NON-IT FOC INSIDE CABLE TRAY
	PROPOSED PEDESTAL WITH GUARD RAIL
	PEDESTAL
PVC	POLYVINYL CHLORIDE CONDUIT
FOC	FIBER OPTIC CABLE
TBD	TO BE DETERMINED
PED	PEDESTAL
PIB	PROCESS INTERFACE BUILDING
SS	SUBSTATION BUILDING
CCR	CENTRAL CONTROL ROMM
IT	INFORMATION TECHNOLOGY
NON-IT	NON-INFORMATION TECHNOLOGY
P-P	PEDESTAL TO PEDESTAL
W-P	WALL TO PEDESTAL
P-E	PEDESTAL TO END
	NON-IT FOC CABLE ROUTING

REFERENCE DRAWING

DRAWING No	TITLE
2270-8540-80-O002-0029.001	OVERALL FOC CABLE & TRENCH ROUTE
2270-8540-80-O002-0003.001	OVERALL FOC BLOCK DIAGRAM (NON-IT) -PAS
2270-8540-80-O002-0025.001	FOC SCHEMATIC DIAGRAM (PAS)
2270-8540-80-O002-0026.001	FOC SCHEMATIC DIAGRAM (FIRE ALARM)
2270-8540-80-O002-0028.001	FOC SCHEMATIC DIAGRAM (ANALYZERS)

KEY PLAN

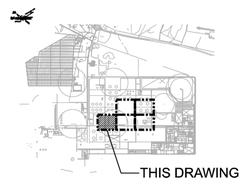

0 12.5 25 75.53 m 87.76 m 50 62.5 75
1: 750

REV	DATE	DESCRIPTION	DRWN BY	CHKD BY	APPD BY
CO	06/01/26	ISSUED FOR PROPOSAL	BGA	HSB	HSW

REVISIONS

RABIGH REFINING AND PETROCHEMICAL COMPANY

بترو رابغ
Petro Rabigh

DWG CODE	DWG CODE DESCRIPTION
80	OVERALL FOC CABLE & TRENCH ROUTE

PAS / FIRE ALARM / ANALYZERS

BOTB PROJECT

PROJECT NO.	PLANT	DRAWING NUMBER	SHT	REV.
213011-01022	O002	2270-8540-80-O002-0029	002	CO

BASE REVISION

REPRODUCED, COPIED, LENT, OR DISPOSED OF DIRECTLY OR INDIRECTLY NOR USED FOR ANY PURPOSE
THIS DRAWING IS THE PROPERTY OF RABIGH REFINING AND PETROCHEMICAL COMPANY AND IS LENT WITHOUT CONSIDERATION OTHER THAN THE BORROWER'S AGREEMENT THAT IT SHALL NOT BE